

Property / Job
 16-18 Hatton Garden
 Office and Common parts Refurbishment
 Floor / Location
 4th Floor

Drawing reference
 As Built Plan

Scale: 1:75 @ A3 Date: 16.10.19





Axiom Solutions Limited
 www.axiomsolutionsltd.com

Drg No. HG1618_I03.AB.04	Revision. -
-----------------------------	----------------

Rev.	Date.	Issued
-	16.10.19	

Note:
 These drawings should be approved by the Local Authority.
 No dimensions are to be taken from these drawings, check all dimensions on site.
 This drawing is subject to copyright and should not be reproduced without the permission of Axiom Solutions Ltd.

1 Hatton Garden 4th Floor General Arrangement
 Scale: 1:75

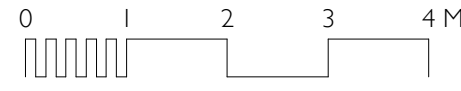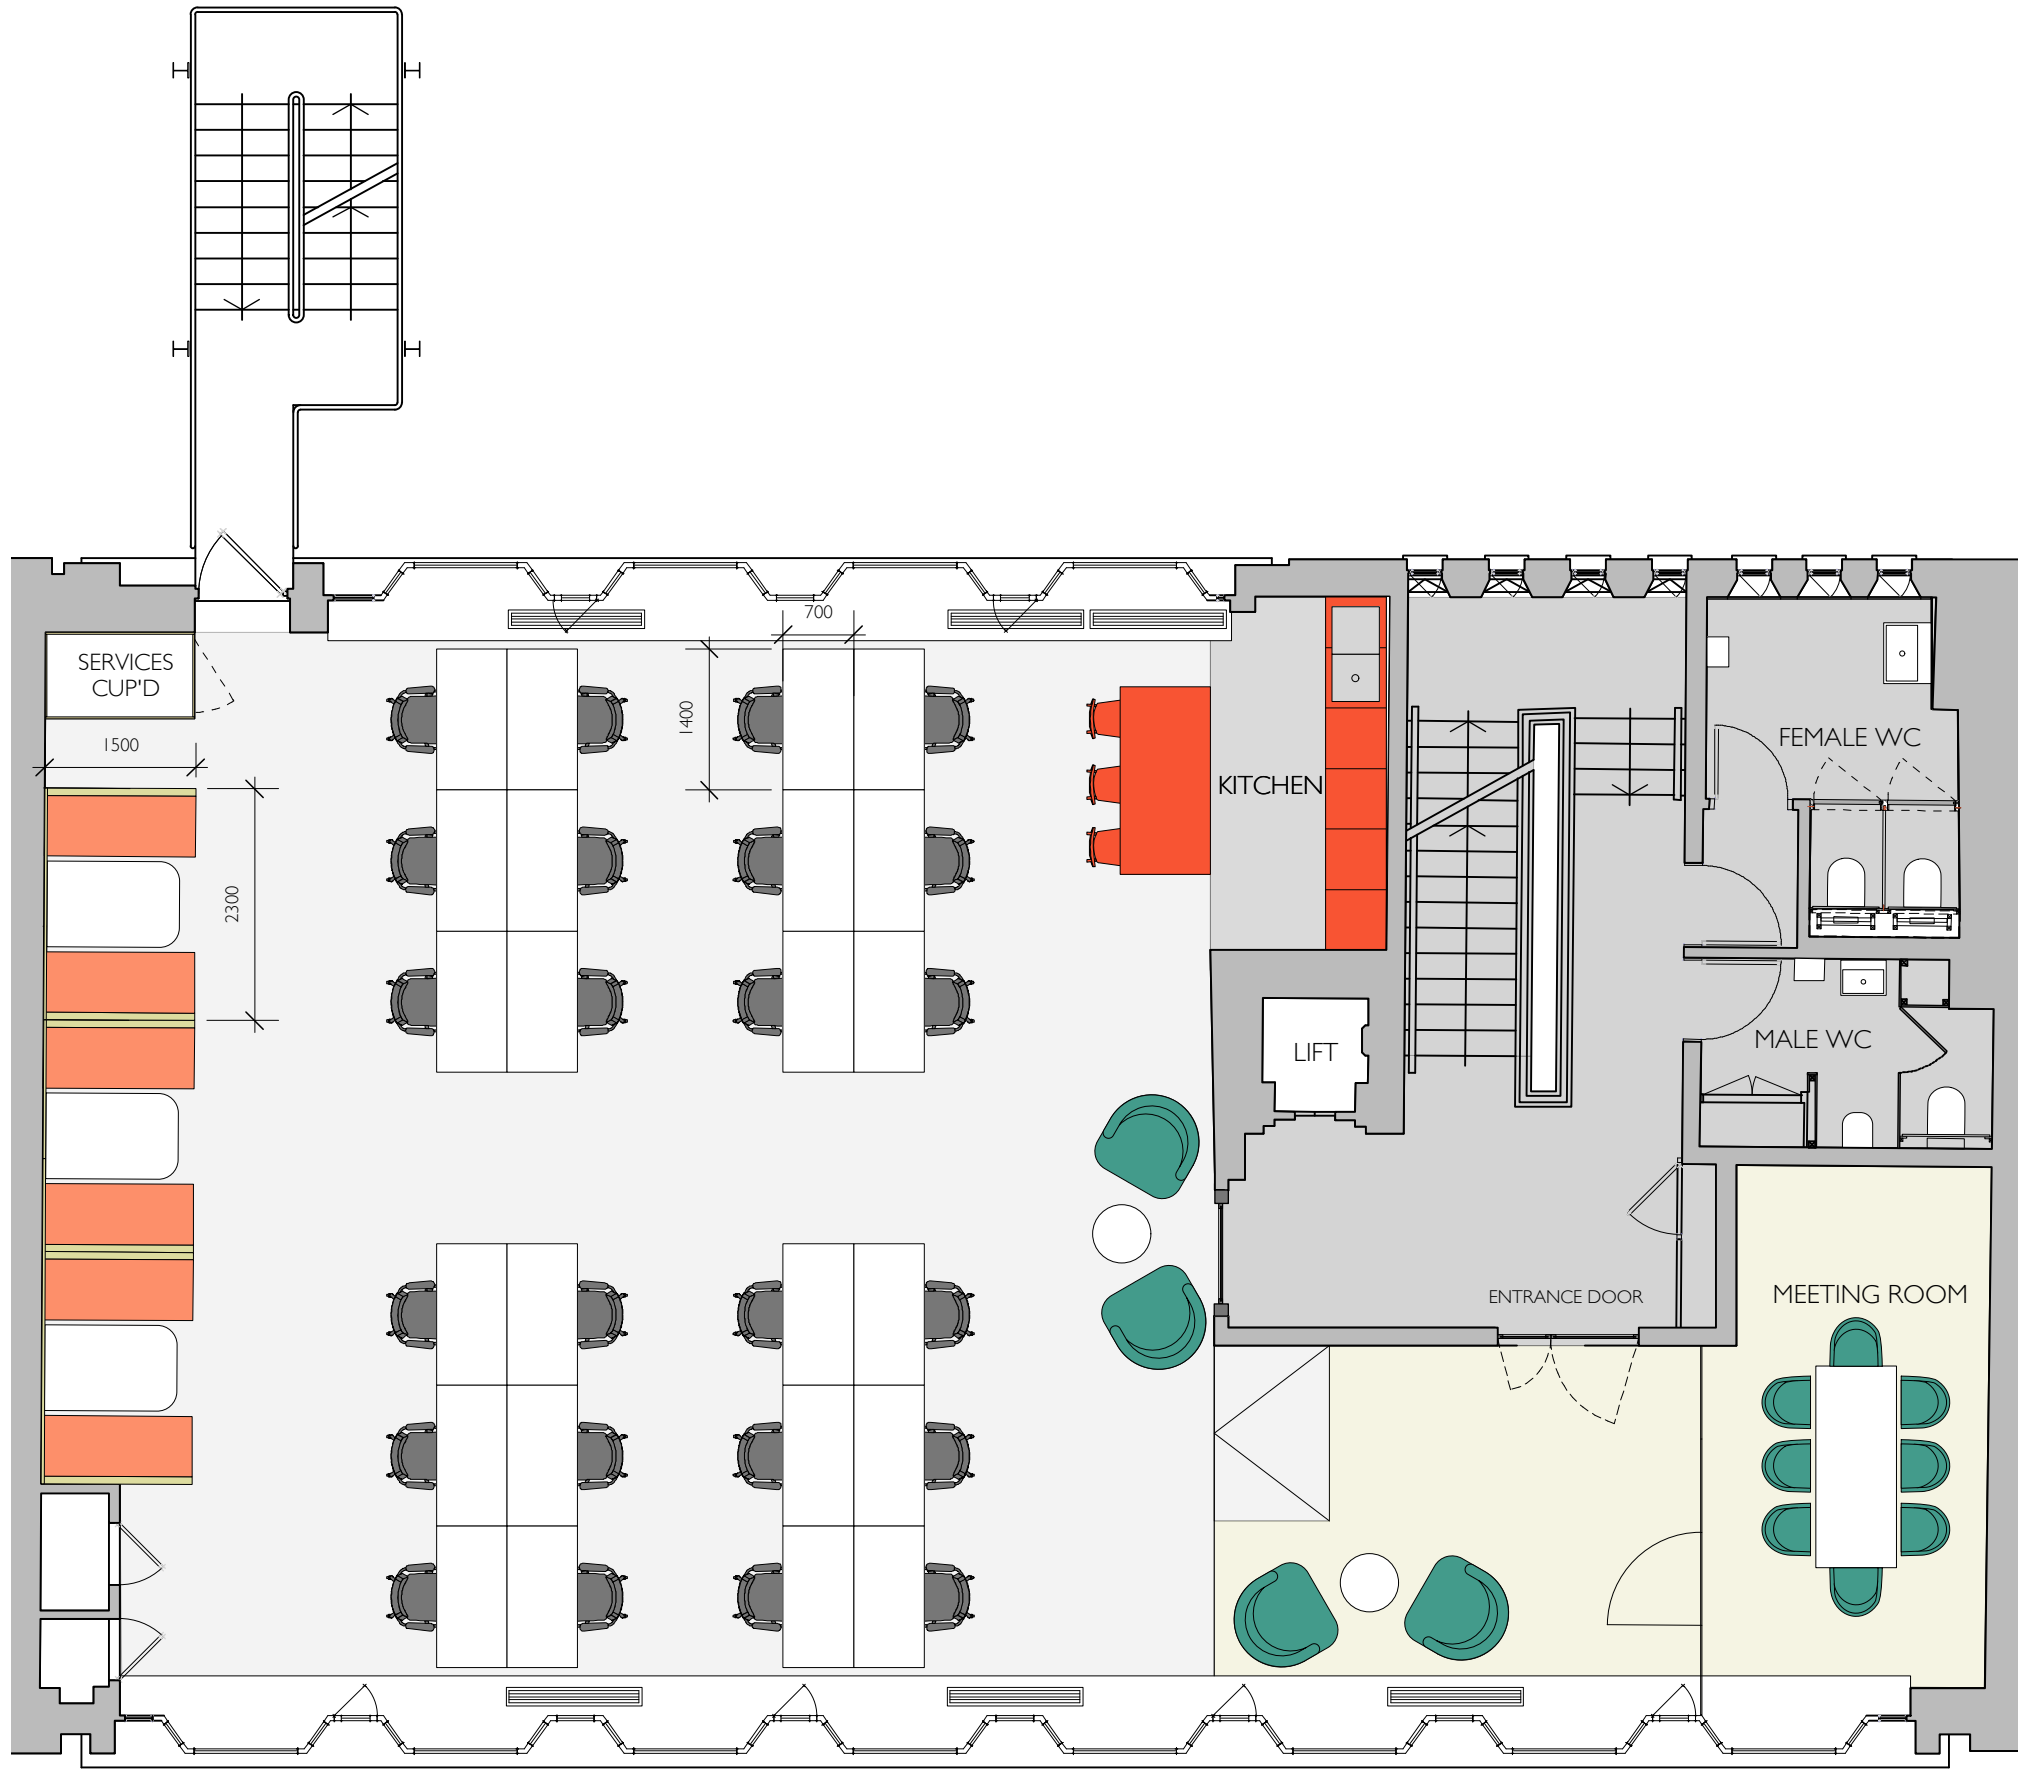

Property / Job
 16-18 Hatton Garden
 Office and Common parts Refurbishment
 Floor / Location
 4th Floor

Drawing reference
 As Built - Furniture Layout

Scale:
 1:75 @ A3

Date:
 16.10.19

1 Hatton Garden 4th Floor Furniture Layout
 Scale: 1:75

Axiom Solutions Limited www.axiomsolutionsltd.com		
Drg No. HG1618_103.AB.04.01		Revision. -
Rev.	Date.	Issued
-	16.10.19	



Note:
 These drawings should be approved by the Local Authority.
 No dimensions are to be taken from these drawings, check all dimensions on site.
 This drawing is subject to copyright and should not be reproduced without the permission of Axiom Solutions Ltd.